



The University of Texas at San Antonio

Facilities Planning & Development  
One UTSA Circle  
San Antonio, Texas 78249  
210.458.4933  
210.458.4266  
http://facilities.utsa.edu

By acceptance and use of these drawings, the recipient acknowledges the limitation and accuracy of the information being provided by UTSA, and will abide by the following terms and conditions: UTSA CAD files and other drawings are provided as a courtesy. UTSA CAD files/drawings should be viewed for general information only. Existing conditions may vary from what is depicted in these files. They do not necessarily show actual "as-built" conditions. Information provided on general information. The recipient is prohibited from transmittal of these documents to other entities without the express written consent of UTSA.

DATE	UPDATED BY:
05.31.17	JTC
10.17.17	JTC
03.29.18	JTC
09.25.18	JTC

BUILDING NAME  
PETER T FLAWN BUILDING

BUILDING ADDRESS  
MAIN CAMPUS  
One UTSA Circle  
San Antonio, Texas 78249

BUILDING NUMBER  
KEY PLAN


SHEET TITLE

Floor Plan Level 3

SHEET NUMBER

SEC-103

PAGE#84

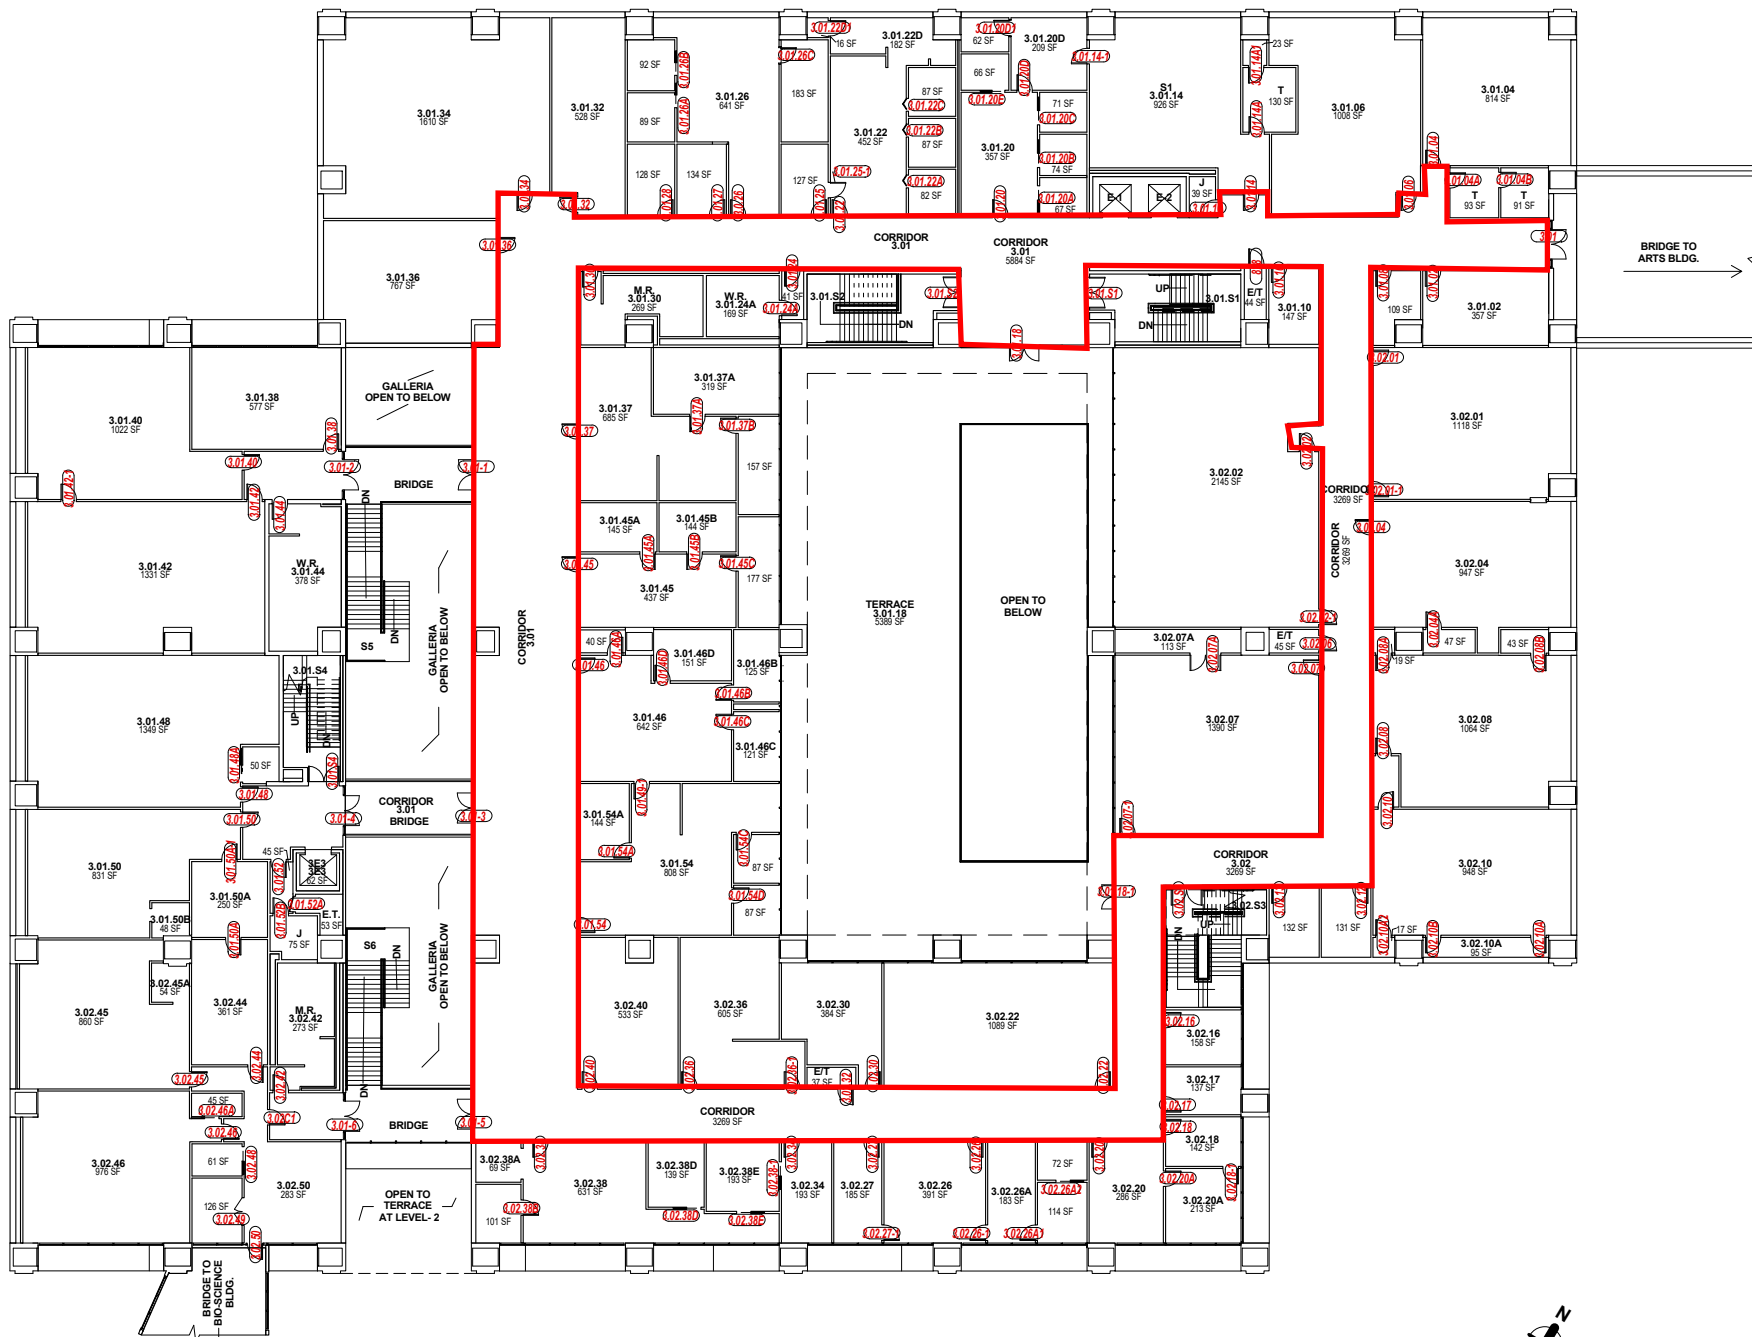

1 Floor Plan Level 3  
SCALE: NTS